

NO.	DATE	REV. BY	DESCRIPTION
1	5/10/21	SM	ADDED HEIGHT DIMENSION TO GATE STRUCTURE





VERIFY SCALE	BAR IS ONE INCH ON ORIGINAL DRAWING
--------------	-------------------------------------

DESIGN	DESIGN D. COWELL
REVIEW	CHECKED S. MEYER
APPROVED	APPROVED B. PACKER

RECORD DRAWINGS	SOUTH VALLEY WATER RECLAMATION FACILITY WEST JORDAN, UTAH
-----------------	--

EXISTING 90-IN PIPELINE - 3	PROJECT NUMBER 177-20-01
-----------------------------	-----------------------------

DRAWING NO. RD-07	DATE: APRIL 2021
----------------------	------------------

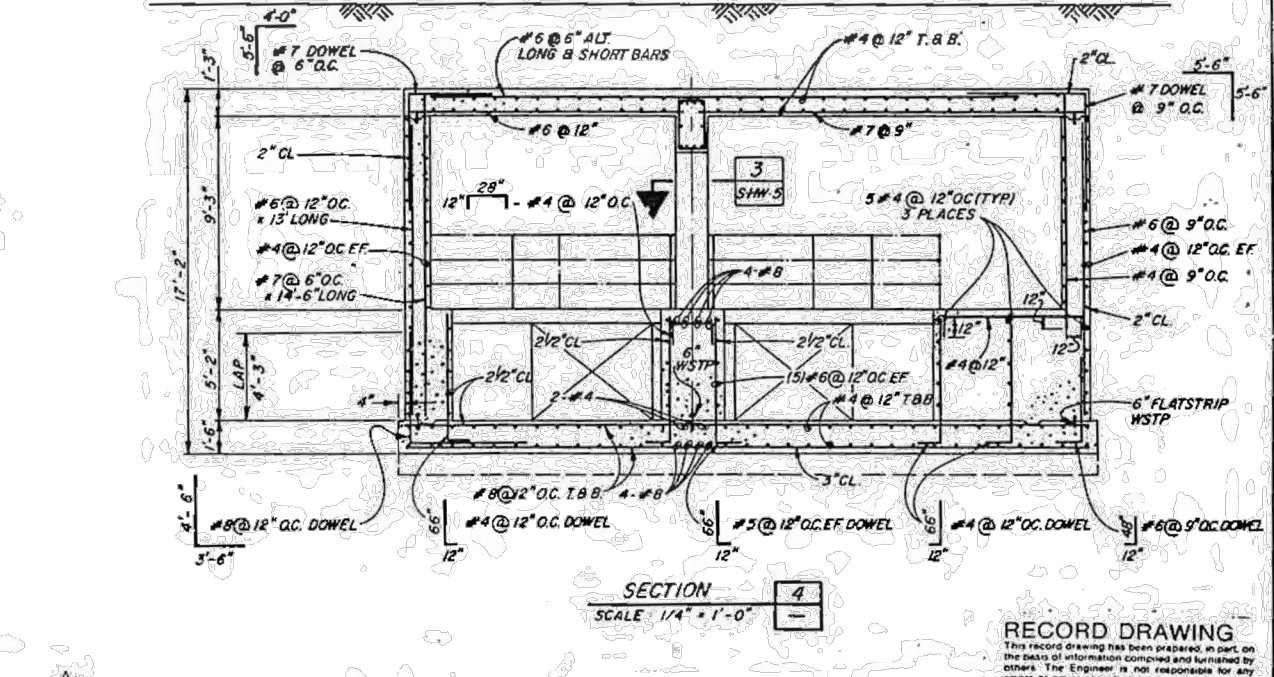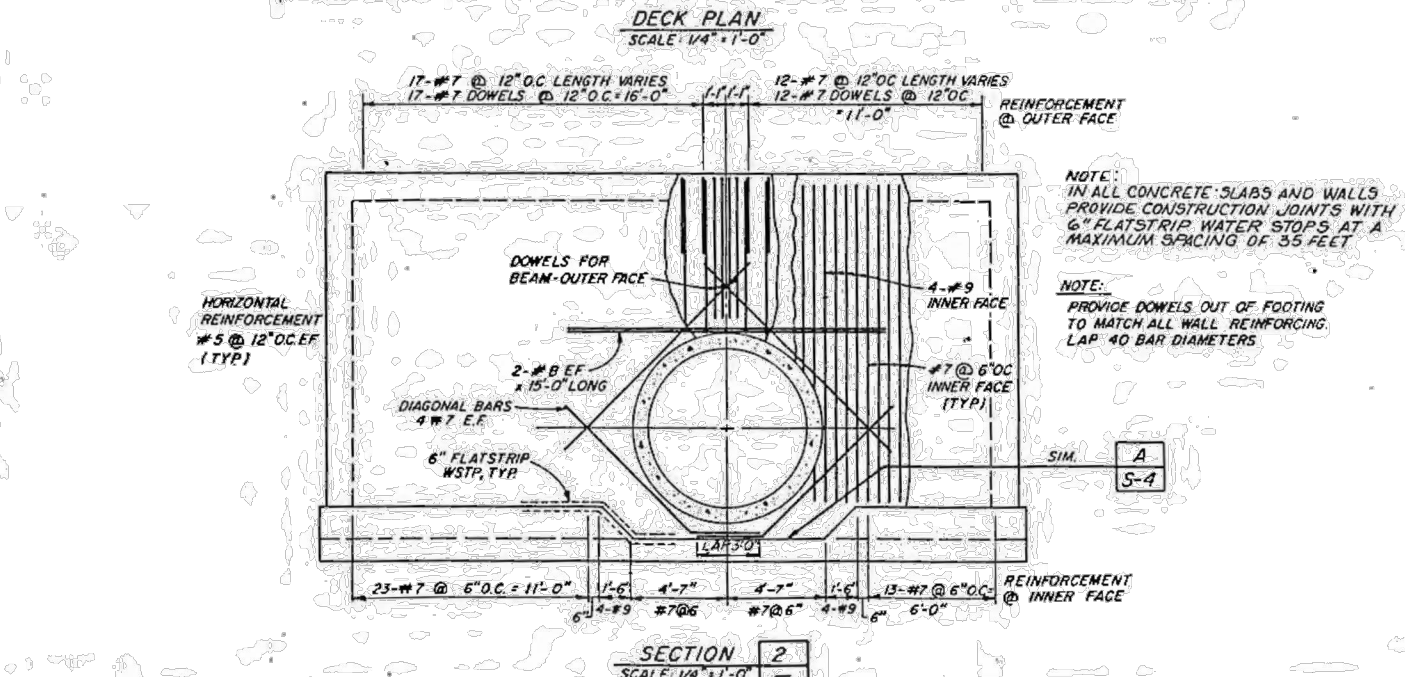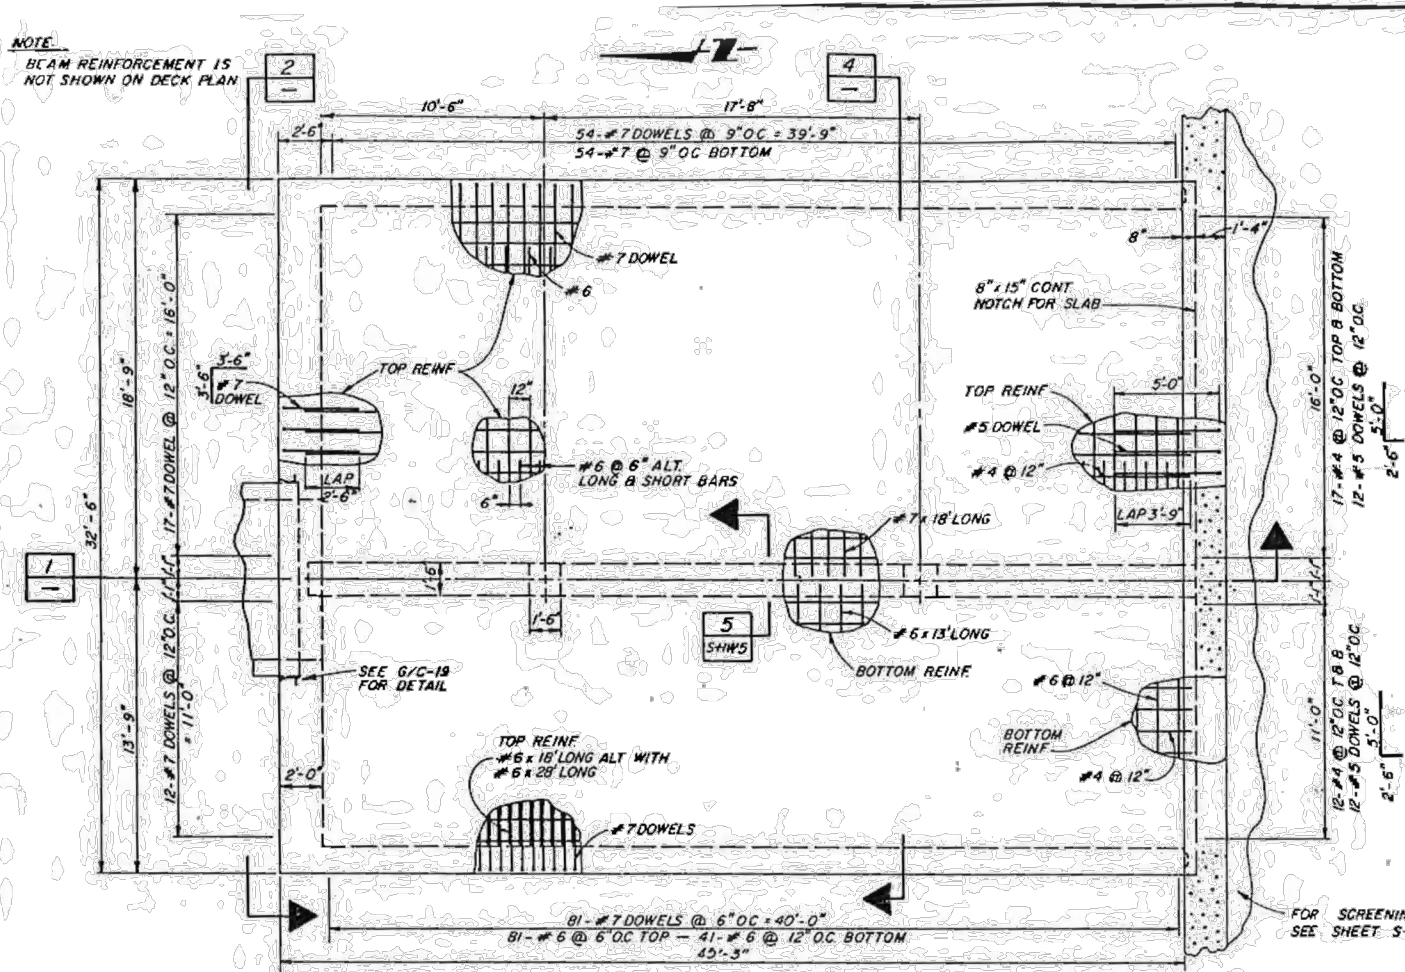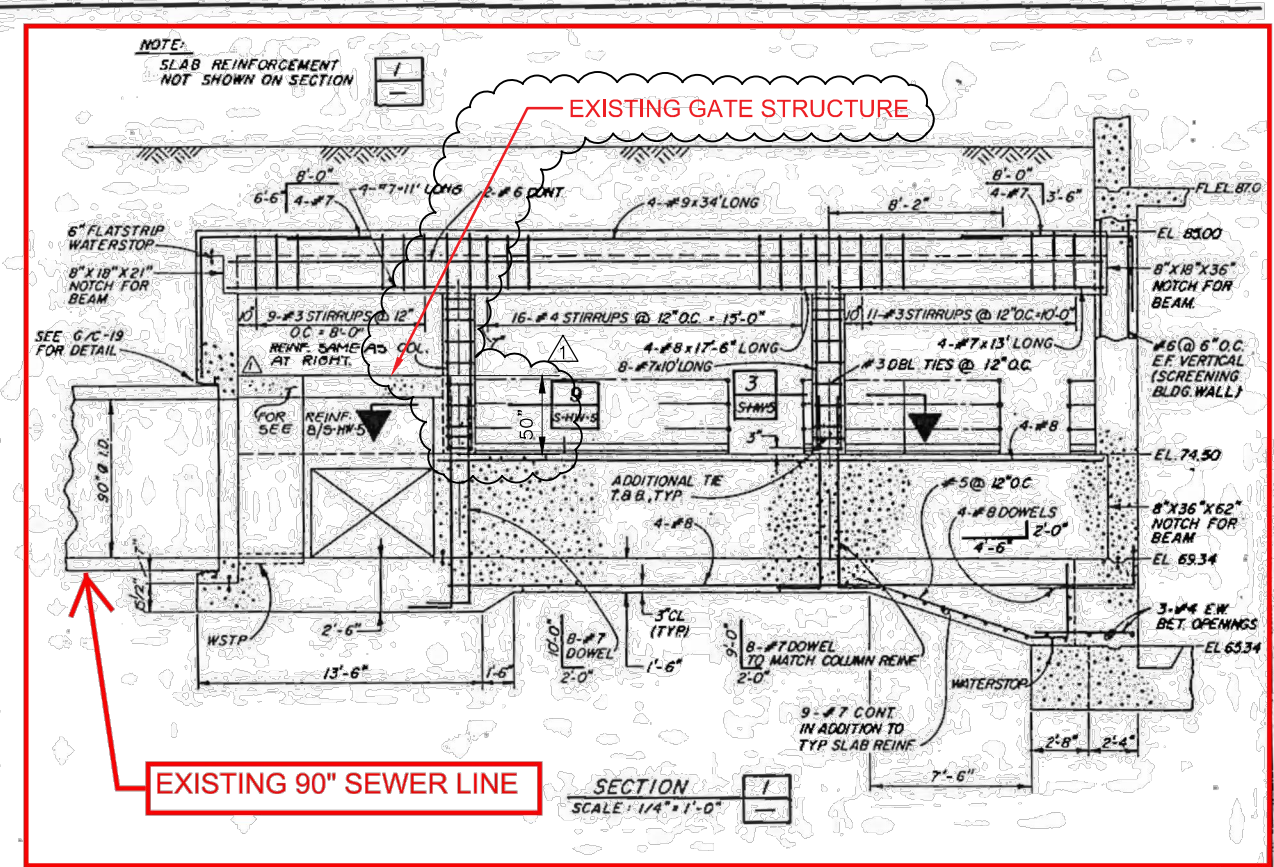

RECORD DRAWING
This record drawing has been prepared, in part, on the basis of information compiled and furnished by others. The Engineer is not responsible for any errors or omissions which have been incorporated into this document as a result.

DESIGNED: <i>James M. Montgomery</i>	SUBMITTED: <i>James M. Montgomery</i>	PROJECT ENGINEER: <i>James M. Montgomery</i>	RECOMMENDED: <i>James M. Montgomery</i>	JAMES M. MONTGOMERY CONSULTING ENGINEERS INC.	SOUTH VALLEY WATER RECLAMATION FACILITY	SOUTH VALLEY JOINT ADMINISTRATIVE BOARD	SHEET S-HW-4
SCALE: AS NOTED	DATE: 5-12-21	DATE: 5-12-21	DATE: 5-12-21	DATE: 5-12-21	PROJECT 2A	FLUME ROOM - DECK PLAN & SECTIONS	OF SHEETS