
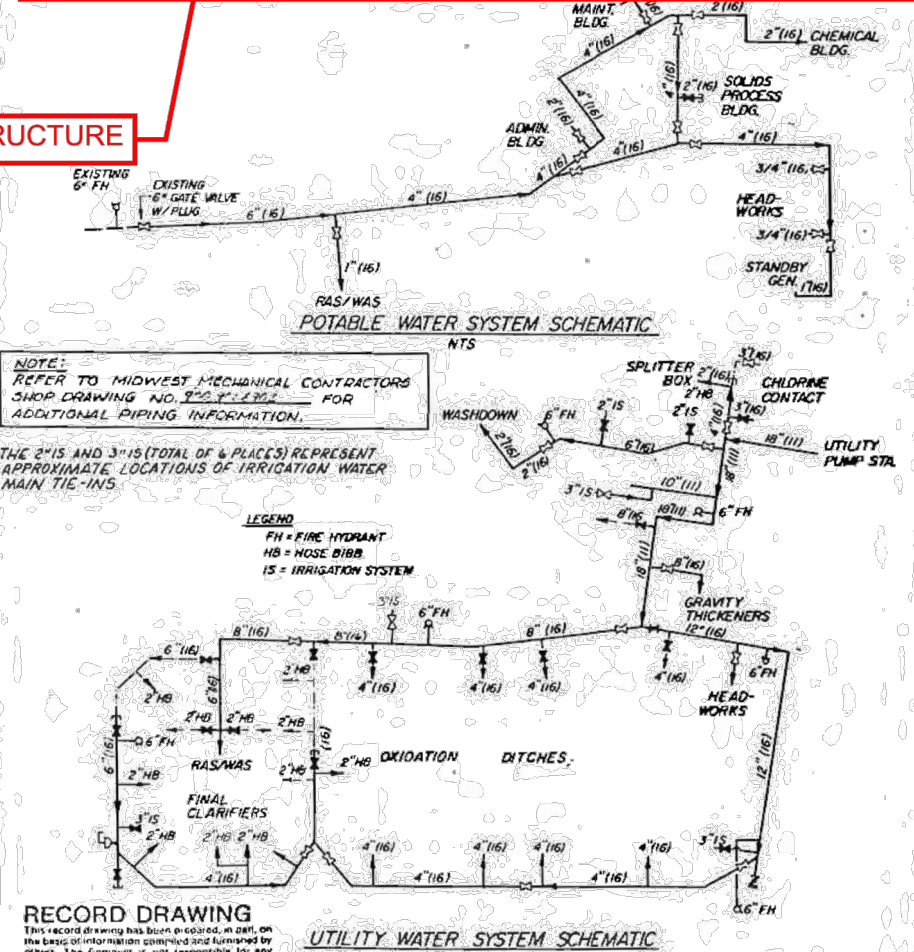
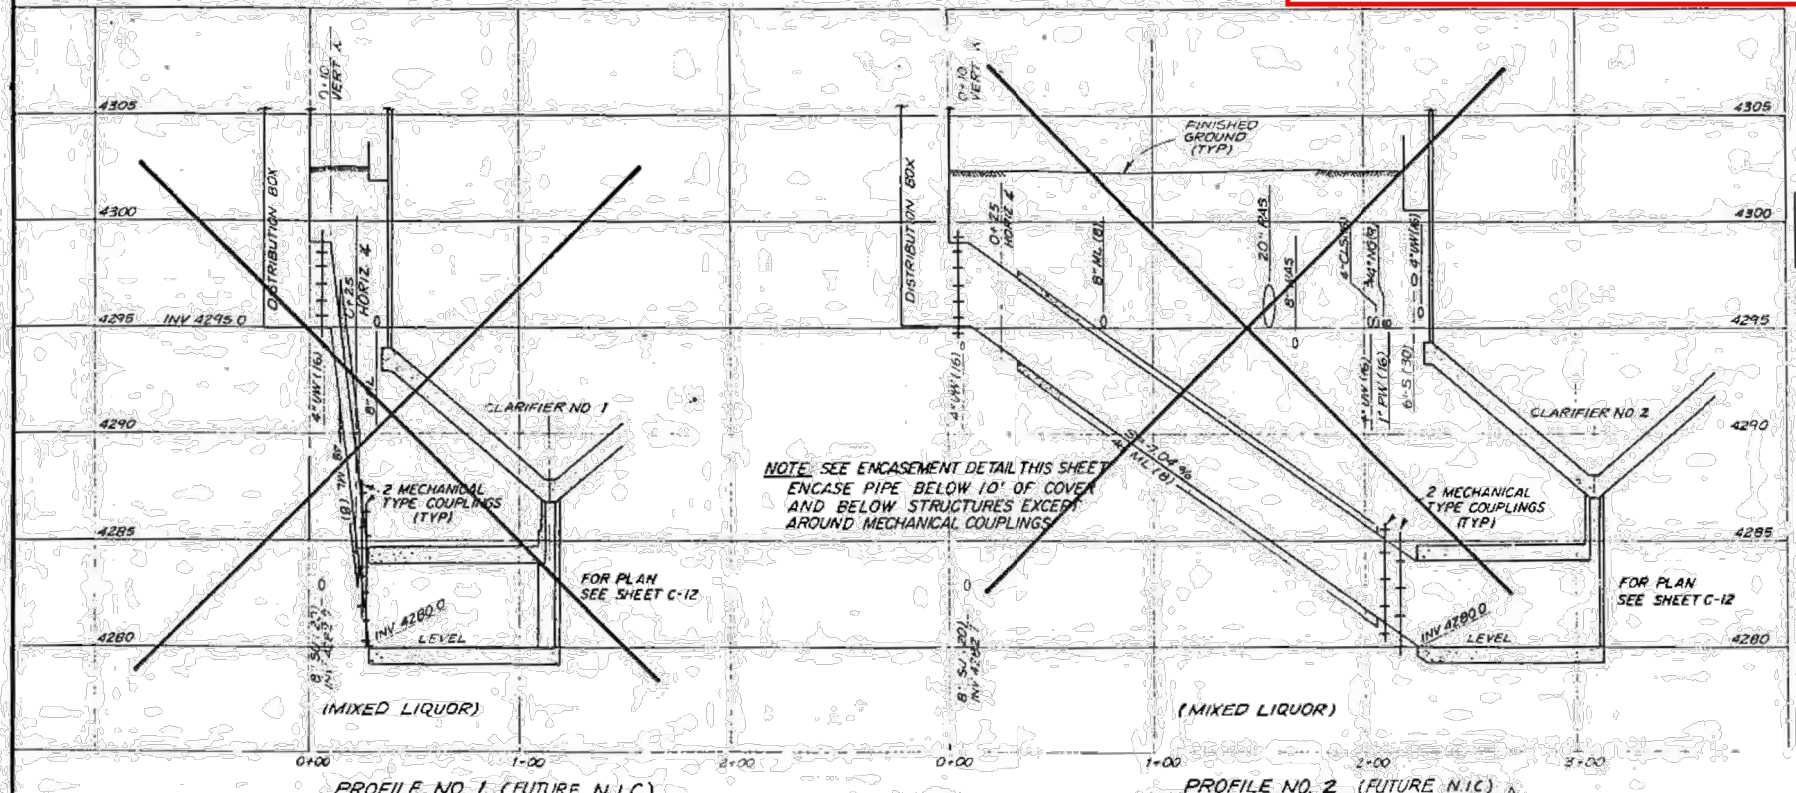
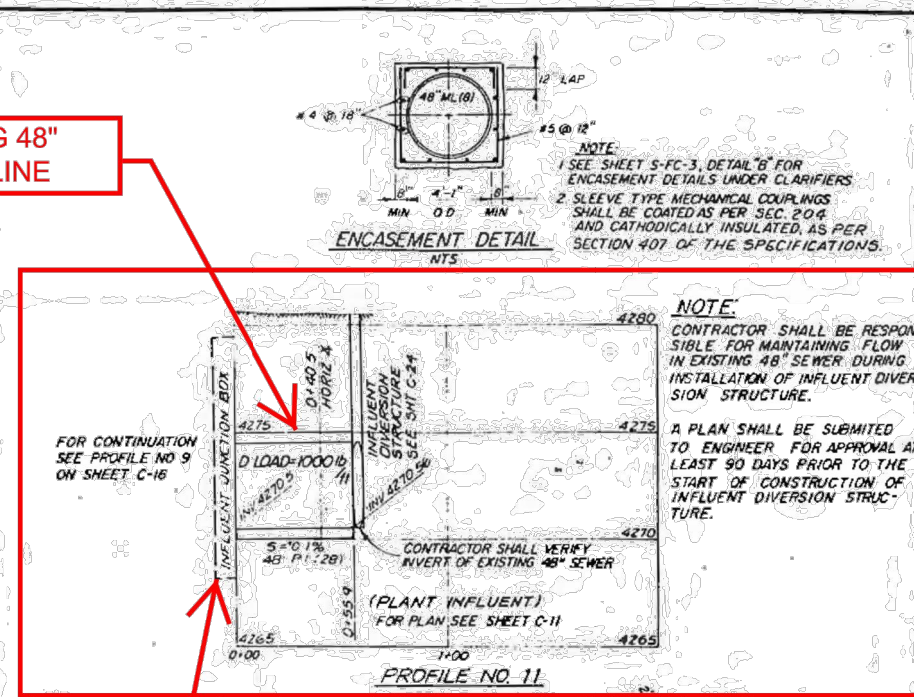


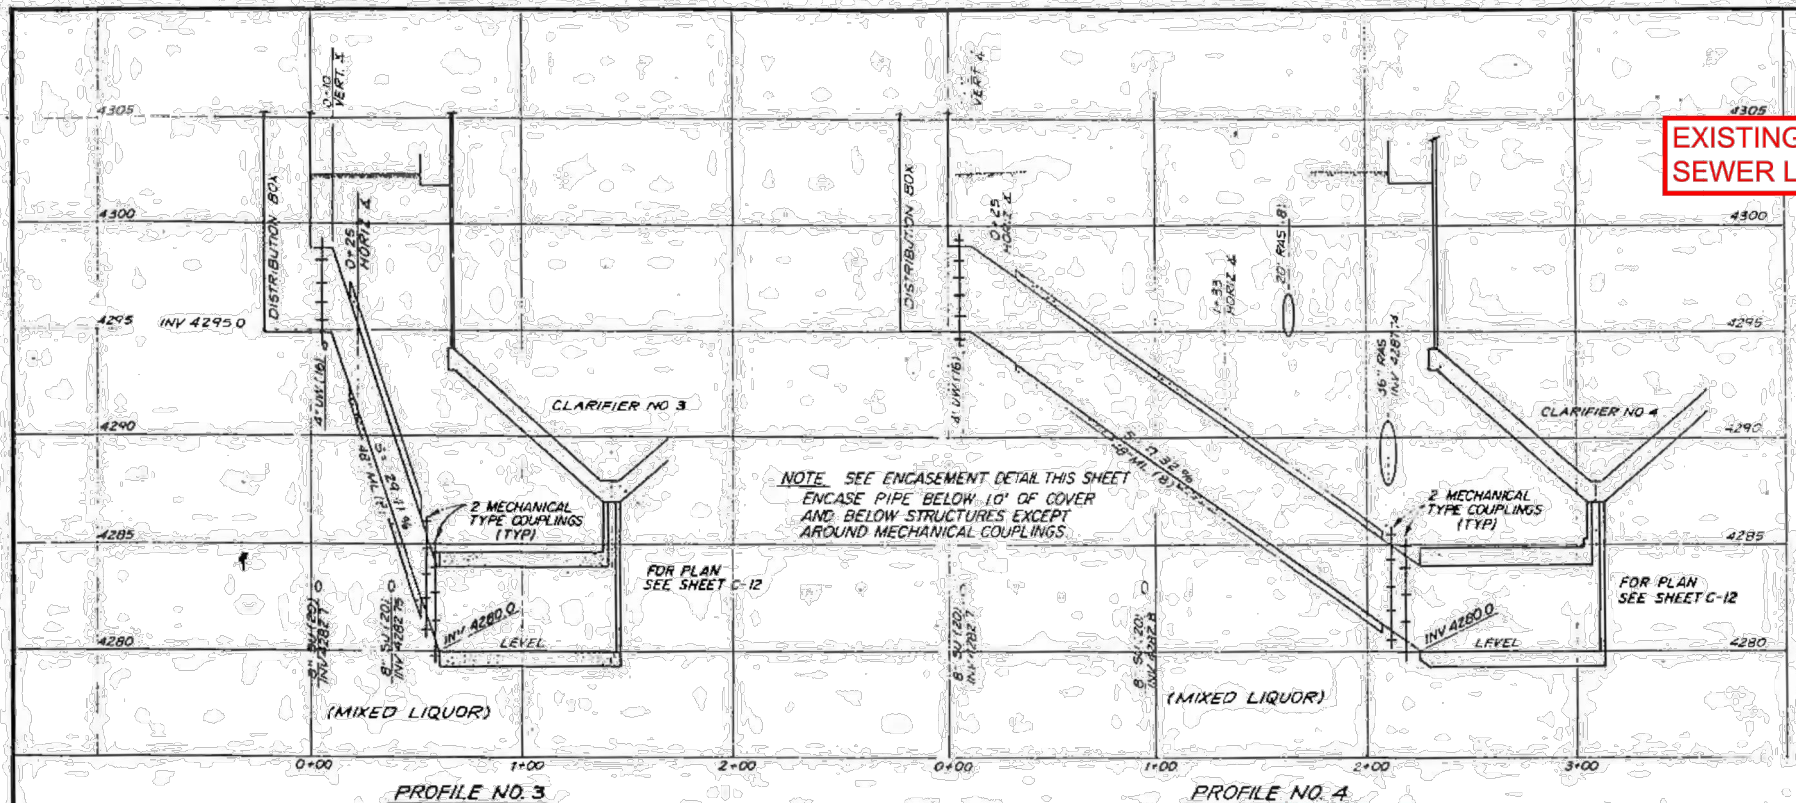

SCALE: VERT 1"=4' HORIZ 1"=40'		DESIGNED BY <i>James M. Montgomery</i>	SUBMITTED BY <i>James M. Montgomery</i>	DATE 10/20/2021	JAMES M. MONTGOMERY CONSULTING ENGINEERS, INC.	SOUTH VALLEY WATER RECLAMATION FACILITY	SOUTH VALLEY JOINT ADMINISTRATIVE BOARD		SHEET C-14
DRAWN BY <i>C. DUNCAN</i>		RECOMMENDED BY <i>James M. Montgomery</i>	DATE 10/20/2021	PROJECT 2A			YARD PIPING PROFILES		
REV	DATE	BY	DESCRIPTION						

BOWEN COLLINS & ASSOCIATES

PROFESSIONAL ENGINEER
#343839
BRENT R. COLLINS
STATE OF UTAH
4/9/2021

NO.	DATE	REV. BY	DESCRIPTION

SOUTH VALLEY WATER RECLAMATION FACILITY
WEST JORDAN, UTAH

SOUTH SEWER INTERCEPTOR CIPP PROJECT

DESIGN D. COWELL
DRAWN S. DUCKWORTH

REVIEW
CHECKED S. MEYER
APPROVED B. PACKER

VERIFY SCALE
BAR IS ONE INCH ON ORIGINAL DRAWING

RECORD DRAWINGS

EXISTING NORTH CONFLUENCE STRUCTURE - 2

DATE: APRIL 2021
PROJECT NUMBER: 177-20-01

DRAWING NO.
RD-04

SHEET **27** OF **37**

